

STATE ENGINEER
Salem, Oregon

UMAT
4918

Well Record

STATE WELL NO. 6N/35-33J
COUNTY Umatilla
APPLICATION NO. GR-3770

OWNER: Walter W. Roloff


MAILING ADDRESS: Route 3, Box 349

LOCATION OF WELL: Owner's No.

CITY AND STATE: Milton-Freewater, Oregon

NE 1/4 SE 1/4 Sec. 33 T. 6 N. S. R. 35 E. W.M.

Bearing and distance from section or subdivision corner 1195' South and 1210' West of NE 1/4 Cor. of Section 33

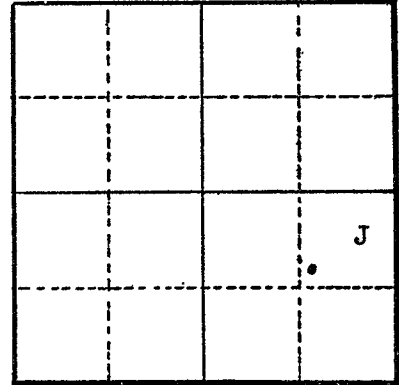

Section 33

Altitude at well 850 feet

TYPE OF WELL: 25' Drilled 45' Dug Date Constructed 1908

Depth drilled 68 feet Depth cased 68 feet

CASING RECORD:

72-inch concrete set to 16 feet
8-inch steel set from 45 feet to 68 feet

FINISH:

AQUIFERS:

WATER LEVEL:

30 feet

PUMPING EQUIPMENT: Type Turbine - Cook - 6" H.P.
Capacity 550 G.P.M.

WELL TESTS:

Drawdown ft. after hours G.P.M.
Drawdown ft. after hours G.P.M.

USE OF WATER Irrigation Temp. °F., 19

SOURCE OF INFORMATION GR-4009

DRILLER or DIGGER

ADDITIONAL DATA:

Log (NA) Water Level Measurements Chemical Analysis Aquifer Test

REMARKS: