

STATE ENGINEER
Salem, Oregon

UMAT
4919

Well Record

STATE WELL NO. 6N/35-33H
COUNTY Umatilla
APPLICATION NO. GR-4228

OWNER: Wm. J. & Carolyn K. Jackson


MAILING ADDRESS: Route 2, Box 318

LOCATION OF WELL: Owner's No. _____

CITY AND STATE: Milton-Freewater, Oregon

SE 1/4 NE 1/4 Sec. 33 T. 6 N. S. R. 35 W., W.M.

Bearing and distance from section or subdivision
corner 100' W. & 150' N. of E 1/4 Cor. Sec. 33

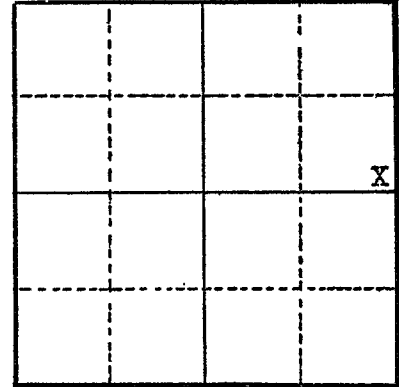

Section 33

Altitude at well _____

TYPE OF WELL: Drill ^{Dug 75'} 120' Date Constructed 1895

Depth drilled 120 ft. Depth cased _____

CASING RECORD:

FINISH:

AQUIFERS:

WATER LEVEL:

30 feet below surface

PUMPING EQUIPMENT: Type Peerless turbine H.P. 10
Capacity 600 G.P.M.

WELL TESTS:

Drawdown _____ ft. after _____ hours _____ G.P.M.
Drawdown _____ ft. after _____ hours _____ G.P.M.

USE OF WATER Irrigation Temp. _____ °F. _____, 19_____
SOURCE OF INFORMATION Well Registration Statement Cert. # GR-3767

DRILLER or DIGGER _____

ADDITIONAL DATA:

Log _____ Water Level Measurements _____ Chemical Analysis _____ Aquifer Test _____

REMARKS: