

STATE ENGINEER  
Salem, Oregon

UMAT  
4964

# Well Record

STATE WELL NO. 6N/35-34D(1)  
COUNTY Umatilla  
APPLICATION NO. GR-1138

GR- 1098

OWNER: John H. Brinker

MAILING  
ADDRESS:


LOCATION OF WELL: Owner's No.

CITY AND  
STATE:

Milton-Freewater, Oregon

N. E.  
NW 1/4 NW 1/4 Sec. 34 T. 6 N., R. 35 W.M.

Bearing and distance from section or subdivision  
corner 665' S. & 1422' W. from N.E. cor. of Sec. 34.

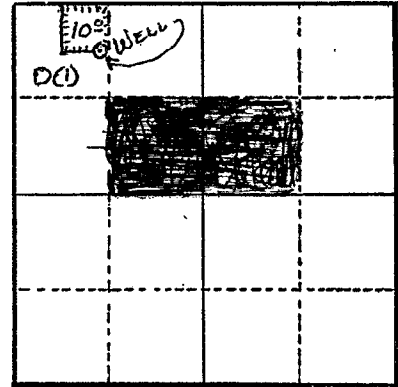

Section 34

Altitude at well 800 ft.

TYPE OF WELL: Dug & Dr'd Date Constructed 1926

Depth drilled 100 ft. Depth cased 100 ft.

### CASING RECORD:

6' x 6' dug hole from 0 to 45 ft.  
6 inch casing from 0 to 100 ft.

### FINISH:

### AQUIFERS:

### WATER LEVEL:

40 ft. (August reading)

PUMPING EQUIPMENT: Type Jacuzzi turbine H.P. 3

Capacity 175 G.P.M.

### WELL TESTS:

Drawdown ft. after hours G.P.M.

Drawdown ft. after hours G.P.M.

USE OF WATER Irrigation Temp. °F., 19

SOURCE OF INFORMATION G. R. Record

DRILLER or DIGGER

### ADDITIONAL DATA:

Log N.A. Water Level Measurements Chemical Analysis Aquifer Test

### REMARKS:

Irrigation of 10 acres.