

STATE ENGINEER
Salem, Oregon

UMAT
4986

Well Record

STATE WELL NO. 6N/35-34B
COUNTY Umatilla
APPLICATION NO. GR-3168

OWNER: Jessie Reese


MAILING ADDRESS: Route 2, Box 336A

LOCATION OF WELL: Owner's No.

CITY AND STATE: Milton-Freewater, Oregon

NE $\frac{1}{4}$ & SW $\frac{1}{4}$ NW $\frac{1}{4}$ NE $\frac{1}{4}$ Sec. 34 T. 6 N. S. R. 35 E. W., W.M.

Bearing and distance from section or subdivision corner: 10' N. and 320' E.

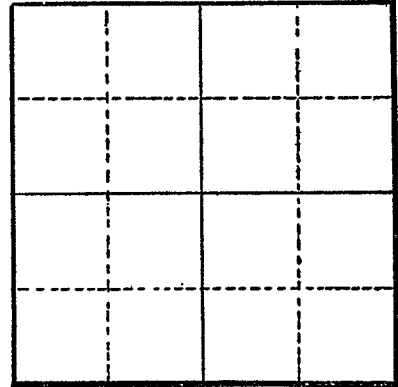

Section

Altitude at well

TYPE OF WELL: dug & drilled Date Constructed 1923

Depth drilled 120' Depth cased 60

CASING RECORD:

60 x 60" concrete curb from 0 to 16'
6" steel from 18 to 60

FINISH:

AQUIFERS:

top soil gravelly
cemented gravel

WATER LEVEL:

20 feet

PUMPING EQUIPMENT: Type H.P. 7 $\frac{1}{2}$
Capacity 250 G.P.M.

WELL TESTS: 10 pumping 250 G.P.M.
Drawdown ft. after hours G.P.M.
Drawdown ft. after hours G.P.M.

USE OF WATER Irrigation Temp. °F., 19

SOURCE OF INFORMATION GR-2966

DRILLER or DIGGER

ADDITIONAL DATA:
Log Water Level Measurements Chemical Analysis Aquifer Test

REMARKS:

top soil gravelly 3 to 3
cement gravel 117 to 120