

STATE ENGINEER
Salem, Oregon

UMAT
4987

Well Record

STATE WELL NO. 6N/35-34L
COUNTY Umatilla
APPLICATION NO. GR-1597


GR- 1549

OWNER: Donald J. LaMotte
MAILING ADDRESS: Box 6

LOCATION OF WELL: Owner's No. CITY AND STATE: Milton-Freewater, Oregon

NE 1/4 SW 1/4 Sec. 34 T. 6 N. R. 35 E. W.M.

Bearing and distance from section or subdivision corner 470.5' W. & 1610' N. from S 1/4 cor. Sec. 34

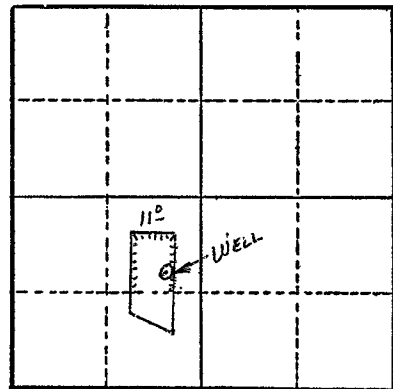

Altitude at well 875'

TYPE OF WELL: Dug Date Constructed Prior to 1922

Depth drilled 48' Depth cased 15'

Section 34

CASING RECORD:

72" x 72" concrete curbing from 0 to 15 ft.

FINISH:

AQUIFERS:

WATER LEVEL:

40' in May 1958

PUMPING EQUIPMENT: Type 3" Cent. H.P. 10
Capacity 350 G.P.M.

WELL TESTS:

Drawdown 4 - 6 ft. after hours 250 G.P.M.
Drawdown ft. after hours G.P.M.

USE OF WATER Irrigation Temp. °F. 19

SOURCE OF INFORMATION GR record

DRILLER or DIGGER

ADDITIONAL DATA:

Log Water Level Measurements Chemical Analysis Aquifer Test

REMARKS:

Log: Gravely loam 0 to 3 ft.
Cement gravel & cobbles 3 to 48 ft.

Irrigation of 11 acres.