

STATE ENGINEER
Salem, Oregon

UMAT
4988

Well Record

STATE WELL NO. 6N/35-34D(2)
COUNTY Umatilla
APPLICATION NO. GR-1270

GR- 1226

OWNER: Samuel H. Brinker

MAILING
ADDRESS:


LOCATION OF WELL: Owner's No.

CITY AND
STATE:

Milton-Freewater, Oregon

N. E.
NW 1/4 NW 1/4 Sec. 34 T. 6 R. 35 W.M.

Bearing and distance from section or subdivision
corner 645' E. & 640' S. from NW cor. Sec. 34.

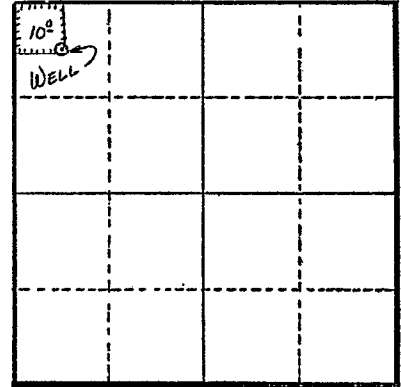

Section 34

Altitude at well 790 ft.

TYPE OF WELL: Dug&Drilled Date Constructed 1921

Depth drilled 85 ft. Depth cased Approx. 10 ft.

CASING RECORD:

6 x 6 ft. from 0 to 10 ft. ???

FINISH:

AQUIFERS:

WATER LEVEL:

45 ft. (August)

PUMPING EQUIPMENT: Type Peerless turbine H.P. 3

Capacity 150+ G.P.M.

WELL TESTS:

Drawdown ft. after hours G.P.M.

Drawdown ft. after hours G.P.M.

USE OF WATER Irrigation Temp. °F., 19

SOURCE OF INFORMATION G.R. Record

DRILLER or DIGGER

ADDITIONAL DATA:

Log N.A. Water Level Measurements Chemical Analysis Aquifer Test

REMARKS:

Irrigation of 10 acres.