

STATE ENGINEER
Salem, Oregon

UMAT
4999

Well Record


STATE WELL NO. 6N/35-34L
COUNTY Umatilla
APPLICATION NO. GR-4004

OWNER: Mrs. Eddie LeFore
MAILING ADDRESS: Route 2, Box 325

LOCATION OF WELL: Owner's No.
CITY AND STATE: Milton-Freewater, Oregon

NE 1/4 SW 1/4 Sec. 34 T. 6 N. R. 35 E. W.M.

Bearing and distance from section or subdivision
corner 450' S. & 4' W. of NE Cor. SW 1/4 Sec. 34

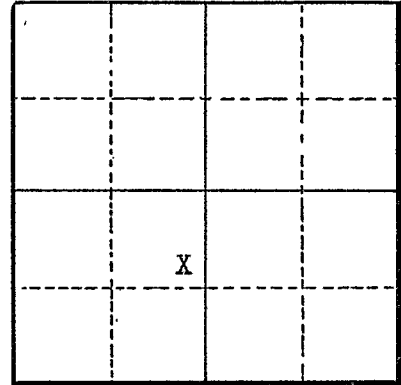

Section 34

Altitude at well

TYPE OF WELL: Dug Date Constructed 3/1/20

Depth drilled 55 ft. Depth cased 12 ft.

CASING RECORD:

72 inch concrete curbing from 0 to 12 feet

FINISH:

AQUIFERS:

WATER LEVEL:

40 feet below surface

PUMPING EQUIPMENT: Type Unity type pump H.P. 3
Capacity 100 G.P.M.

WELL TESTS:

Drawdown 4 ft. after 100 hours G.P.M.

Drawdown ft. after hours G.P.M.

USE OF WATER Irrigation Temp. °F., 19

SOURCE OF INFORMATION Well Registration Statement Cert. # GR-3611

DRILLER or DIGGER

ADDITIONAL DATA:

Log Water Level Measurements Chemical Analysis Aquifer Test

REMARKS: