

STATE ENGINEER
Salem, Oregon

UMAT
4990

Well Record


STATE WELL NO. 6N/35-34K
COUNTY Umatilla
APPLICATION NO. GR-3847

OWNER: Jack D. & Juanita L. Slusarenko MAILING ADDRESS: Route 2, Box 364

LOCATION OF WELL: Owner's No. _____ CITY AND STATE: Milton-Freewater, Oregon

NW 1/4 SE 1/4 Sec. 34 T. 6 N. S., R. 35 W., W.M.

Bearing and distance from section or subdivision corner 1315' S. & 655' E. of center of Sec. 34

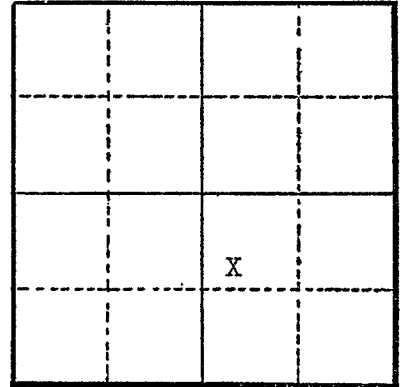

Section 34

Altitude at well _____

TYPE OF WELL: Dug Date Constructed 1920
Depth drilled 50 feet Depth cased 18 feet

CASING RECORD:

72 inches of concrete from 0 to 18 feet

FINISH:

AQUIFERS:

WATER LEVEL:

15 feet below surface

PUMPING EQUIPMENT: Type Sterling centrifugal H.P. 5
Capacity 300 G.P.M.

WELL TESTS:

Drawdown _____ ft. after _____ hours _____ G.P.M.
Drawdown _____ ft. after _____ hours _____ G.P.M.

USE OF WATER Irrigation Temp. _____ °F., 19____

SOURCE OF INFORMATION Well Registration Statement Cert. # GR-3504

DRILLER or DIGGER _____

ADDITIONAL DATA:

Log _____ Water Level Measurements _____ Chemical Analysis _____ Aquifer Test _____

REMARKS: