

STATE ENGINEER  
Salem, Oregon

UMAT  
4991

# Well Record

STATE WELL NO. 6N/35-34G  
COUNTY Umatilla  
APPLICATION NO. GR-3848

OWNER: Jack & Juanita L. Slusarenko


MAILING ADDRESS: Route 2, Box 364

LOCATION OF WELL: Owner's No.

CITY AND STATE: Milton-Freewater, Oregon

SW 1/4 NE 1/4 Sec. 34 T. 6 N. S, R. 35 E. W.M.

Bearing and distance from section or subdivision corner 60' N. & 650' E. of center Sec. 34

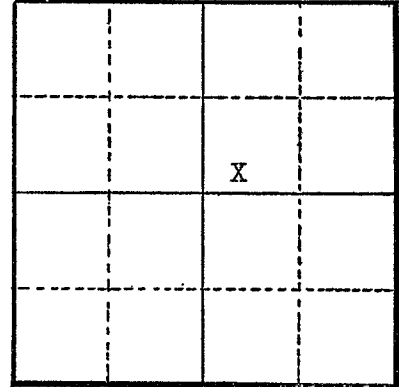

Section 34

Altitude at well

TYPE OF WELL: Dug Date Constructed prior to 1920

Depth drilled 46 feet Depth cased 15 feet

### CASING RECORD:

72 inches concrete set to 15 feet

### FINISH:

### AQUIFERS:

### WATER LEVEL:

20 feet below surface

PUMPING EQUIPMENT: Type Berkley centrifugal H.P. 5  
Capacity 200 G.P.M.

### WELL TESTS:

Drawdown ft. after hours G.P.M.  
Drawdown ft. after hours G.P.M.

USE OF WATER Irrigation Temp. °F., 19

SOURCE OF INFORMATION Well Registration Statement Cert. # GR-3505

DRILLER or DIGGER

### ADDITIONAL DATA:

Log Water Level Measurements Chemical Analysis Aquifer Test

### REMARKS: