

STATE ENGINEER  
Salem, Oregon

UMAT  
4992

# Well Record

GR- 1160

STATE WELL NO. 6N/35-34E(1)  
COUNTY Umatilla  
APPLICATION NO. GR- 1199

OWNER: Nadine & William Whipple

MAILING

ADDRESS: Rt. 2, Box 328

LOCATION OF WELL: Owner's No.


CITY AND

STATE: Milton-Freewater, Oregon

SE 1/4 NW 1/4 Sec. 34 T. 6 N. R. 35 W., W.M.

Bearing and distance from section or subdivision

corner 680' W. & 1650' S. of N 1/4 cor. of Sec. 34.

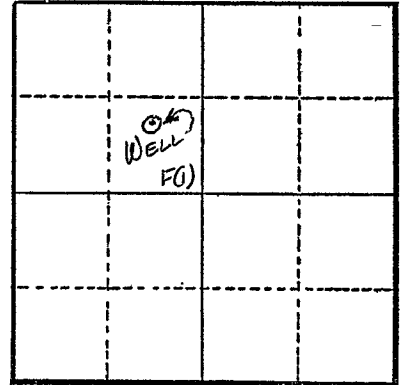

Altitude at well 880 ft.

TYPE OF WELL: Dug&drilled Date Constructed Prior to 1920

Depth drilled 85 ft. Depth cased 60 ft.

Section 34

### CASING RECORD:

8 x 8 ft. concrete from 0 to 20 ft.  
6 inch steel from 40 to 60 ft.

### FINISH:

### AQUIFERS:

### WATER LEVEL:

25 ft.

PUMPING EQUIPMENT: Type Crowe-Kimball Cent. H.P. 2  
Capacity 80 G.P.M.

### WELL TESTS:

Drawdown 15 ft. after hours 80 G.P.M.  
Drawdown ft. after hours G.P.M.

USE OF WATER Irrigation Temp. °F., 19

SOURCE OF INFORMATION G. R. Record

DRILLER or DIGGER

### ADDITIONAL DATA:

Log Water Level Measurements Chemical Analysis Aquifer Test

### REMARKS:

Log: Cobbly loam top soil 0 to 2 ft.  
Cement gravel 2 to 22 ft.  
???? 22 to 85 ft.

Irrigation of 5 acres.