

STATE ENGINEER
Salem, Oregon

UMAT
4993

Well Record

STATE WELL NO. 6N/35-34P(1)
COUNTY Umatilla
APPLICATION NO. GR-1136

GR- 1096

OWNER: Andrew Miller

MAILING
ADDRESS:

Rt. 2, Box 44

LOCATION OF WELL: Owner's No.


CITY AND
STATE:

Milton-Freewater, Oregon

SE 1/4 SW 1/4 Sec. 34 T. 6 N. 35 E. W.M.

Bearing and distance from section or subdivision

corner 10' N. & 650' W. of S 1/4 cor. Sec. 34.

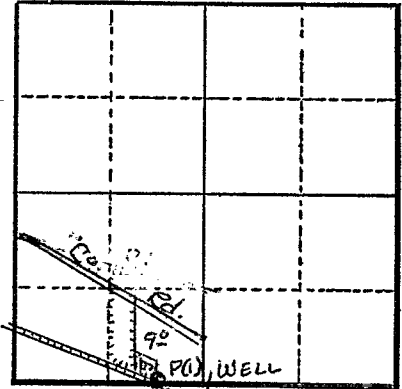

Section 34

Altitude at well 1000 ft.

TYPE OF WELL: Dug Date Constructed 1916

Depth drilled 40 ft. Depth cased 14 ft.

CASING RECORD:

6' x 6' concrete curbing from 0 to 14 ft.

FINISH:

AQUIFERS:

WATER LEVEL:

20 ft.

PUMPING EQUIPMENT: Type 2 1/2 x 2 1/2 in. Cent. H.P. 3
Capacity 200 G.P.M.

WELL TESTS:

Drawdown ft. after hours G.P.M.

Drawdown ft. after hours G.P.M.

USE OF WATER Irrigation Temp. °F., 19

SOURCE OF INFORMATION G. R. Record

DRILLER or DIGGER

ADDITIONAL DATA:

Log Water Level Measurements Chemical Analysis Aquifer Test

REMARKS:

Log: Gravel 0 to 14 ft.
Cement gravel 14 to 40 ft.

Irrigation of 9 acres.