

STATE ENGINEER  
Salem, Oregon

UMAT  
4994

# Well Record

STATE WELL NO. 6N/35-340(1)  
COUNTY Umatilla  
APPLICATION NO. GR-1149

GR- 1112

OWNER: Wilbur Lawrence Gibbons

MAILING

ADDRESS: Rt. 2, Box 17

LOCATION OF WELL: Owner's No.


CITY AND

STATE: Milton-Freewater, Oregon

SW 1/4 SE 1/4 Sec. 34 T. 6 N. R. 35 E. W.M.

Bearing and distance from section or subdivision

corner 660' S. & 10' W. of NE cor. of SW 1/4 SE 1/4 of Section 34.

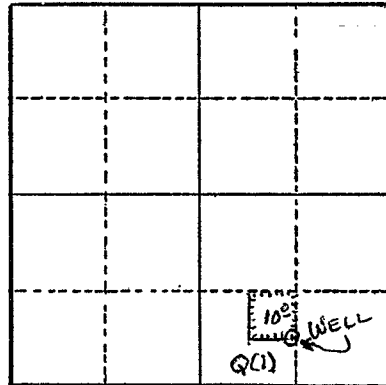

Section 34

Altitude at well 950 ft.

TYPE OF WELL: Dug & drilled. Date Constructed 1916

Depth drilled 80 ft. Depth cased 15 ft.

### CASING RECORD:

6' x 6' concrete curb from 0 to 15 ft.  
8 in. casing set to 80 ft.

### FINISH:

3/8 x 4 in. (4 per ft.) from 45 to 65 ft.

### AQUIFERS:

### WATER LEVEL:

20 ft.

PUMPING EQUIPMENT: Type F. M. 3" Cent. H.P. 5  
Capacity 450 G.P.M.

### WELL TESTS:

Drawdown 20 ft. after \_\_\_\_\_ hours 450 (August 157) G.P.M.  
Drawdown \_\_\_\_\_ ft. after \_\_\_\_\_ hours \_\_\_\_\_ G.P.M.

USE OF WATER Irrigation Temp. \_\_\_\_\_ °F., 19

SOURCE OF INFORMATION G. R. Record

DRILLER or DIGGER

### ADDITIONAL DATA:

Log \_\_\_\_\_ Water Level Measurements \_\_\_\_\_ Chemical Analysis \_\_\_\_\_ Aquifer Test \_\_\_\_\_

### REMARKS:

Log: Top soil 0 to 2 ft.  
Loose gravel 2 to 15 ft.  
Cement gravel 15 to 80 ft.

Irrigation of 10 acres.