

STATE ENGINEER  
Salem, Oregon

UMAT  
4995

# Well Record

GR- 1699


STATE WELL NO. 6N/35-34K  
COUNTY Umatilla  
APPLICATION NO. GR-1752

OWNER: Mae Ferguson  
MAILING ADDRESS: Rt. 2, Box 356

LOCATION OF WELL: Owner's No. \_\_\_\_\_  
CITY AND STATE: Milton-Freewater, Oregon

N. E.  
NW ¼ SE ¼ Sec. 34 T. 6 S. R. 35 W.M.

Bearing and distance from section or subdivision  
corner 605' S. & 656' E. from Center Sec. 34

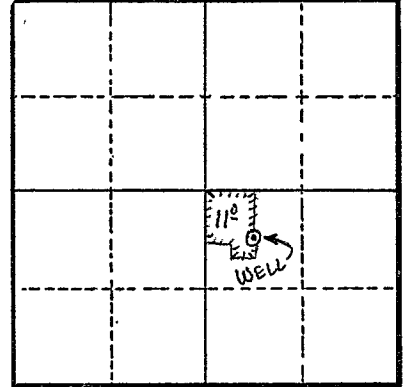

Section 34

Altitude at well 900'

TYPE OF WELL: Dug&Drill! Date Constructed 1916

Depth drilled 198' Depth cased \_\_\_\_\_

### CASING RECORD:

Dug- 7' x 7' x 38'  
Drilled- 8" for 160'

### FINISH:

### AQUIFERS:

### WATER LEVEL:

30' in June

PUMPING EQUIPMENT: Type 2½" x 3" H.P. 3  
Capacity 300 G.P.M.

### WELL TESTS:

Drawdown 30 ft. after \_\_\_\_\_ hours 220 G.P.M.  
Drawdown \_\_\_\_\_ ft. after \_\_\_\_\_ hours \_\_\_\_\_ G.P.M.

USE OF WATER Irrigation Temp. \_\_\_\_\_ °F. \_\_\_\_\_, 19

SOURCE OF INFORMATION GR Record

DRILLER or DIGGER \_\_\_\_\_

### ADDITIONAL DATA:

Log N.A. Water Level Measurements \_\_\_\_\_ Chemical Analysis \_\_\_\_\_ Aquifer Test \_\_\_\_\_

### REMARKS:

Irrigation of 11 acres.