

STATE ENGINEER  
Salem, Oregon

UMAT  
4996

# Well Record

STATE WELL NO. 6N/35-34P  
COUNTY Umatilla  
APPLICATION NO. GR-1598

GR- 1550

OWNER: Donald J. LaMotte


MAILING ADDRESS: Box 6

LOCATION OF WELL: Owner's No.

CITY AND STATE: Milton-Freewater, Oregon

SE 1/4 SW 1/4 Sec. 34 T. 6 N. R. 35 W. W.M.

Bearing and distance from section or subdivision corner 470.5' W. & 1010' N. from S 1/4 cor. Sec. 34

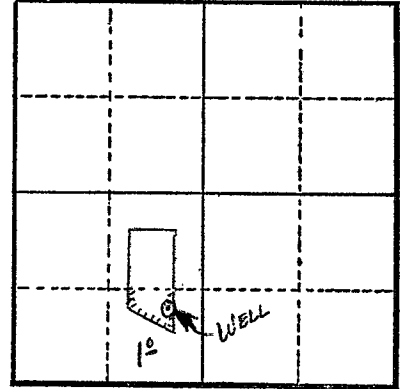

Altitude at well 875'

TYPE OF WELL: Dug Date Constructed 1916 Prior to

Depth drilled 48' Depth cased 15'

Section 34

### CASING RECORD:

6' x 6' concrete curbing from 0 to 15 ft.

### FINISH:

### AQUIFERS:

### WATER LEVEL:

40'

PUMPING EQUIPMENT: Type 1 1/2" Jet H.P. 1  
Capacity 50 to 70 G.P.M.

### WELL TESTS:

Drawdown 2 - 4 ft. after 50 hours G.P.M.

Drawdown ft. after hours G.P.M.

USE OF WATER Irrigation Temp. °F. 19

SOURCE OF INFORMATION GR Record

DRILLER or DIGGER

### ADDITIONAL DATA:

Log Water Level Measurements Chemical Analysis Aquifer Test

### REMARKS:

Log: Gravely loam 0 to 3 ft.  
Cement gravel 3 to 48 ft.

Irrigation of 1.0 acres.