

STATE ENGINEER
Salem, Oregon

UMAT
4997

Well Record

STATE WELL NO. 6N/35-34C
COUNTY Umatilla
APPLICATION NO. GR-3173

OWNER: Jessie Reese


MAILING ADDRESS: Route 2, Box 336A

LOCATION OF WELL: Owner's No.

CITY AND STATE: Milton-Freewater, Oregon

NE 1/4 NW 1/4 Sec. 34 T. 6 N. S. R. 35 E. W. W.M.

Bearing and distance from section or subdivision corner 20' N. and 25' W.

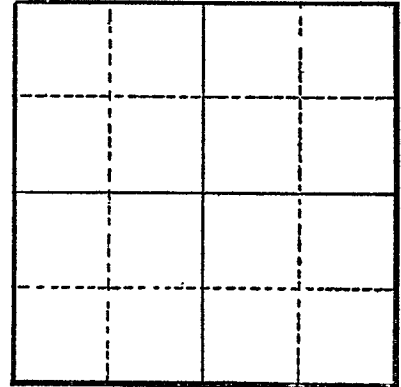

Section

Altitude at well

TYPE OF WELL: dug Date Constructed 4/1/15

Depth drilled 50 Depth cased 15'

CASING RECORD:

60 X 60 inch

FINISH:

AQUIFERS:

Top Soil
Cement Gravel

WATER LEVEL:

20'

PUMPING EQUIPMENT: Type _____ H.P. _____
Capacity _____ G.P.M.

WELL TESTS: 20 ft. after _____ hours pumping 250 G.P.M.
Drawdown _____ ft. after _____ hours _____ G.P.M.

USE OF WATER irrigation Temp. _____ °F. _____, 19

SOURCE OF INFORMATION GR-2971

DRILLER or DIGGER

ADDITIONAL DATA:

Log Water Level Measurements _____ Chemical Analysis _____ Aquifer Test _____

REMARKS:

Top soil 0 to 3
Cement Gravel 47 to 50