

STATE ENGINEER
Salem, Oregon

UMAT
4998

Well Record


STATE WELL NO. 6N/35 - 34R
COUNTY UMATILLA
APPLICATION NO. GR-2247

OWNER: B. A. Phillips Jr. MAILING ADDRESS: P. O. Box 582

LOCATION OF WELL: Owner's No. _____ CITY AND STATE: Milton-Freewater, Oregon

SE 1/4 SE 1/4 Sec. 34 T. 6 N. S., R. 35 E. W., W.M.

Bearing and distance from section or subdivision corner 934' W. and 475' S.

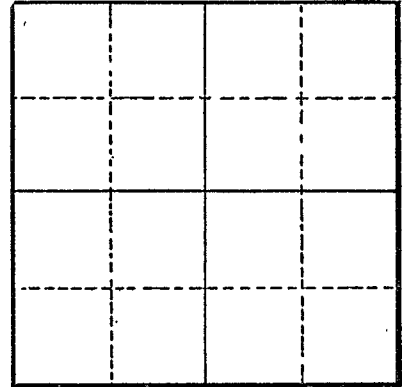

Section _____

Altitude at well _____

TYPE OF WELL: Dug Date Constructed 1915

Depth drilled 40 Depth cased 10

CASING RECORD:

5-Feet

FINISH:

AQUIFERS:

Gravel

WATER LEVEL:

20-Feet

PUMPING EQUIPMENT: Type Centrifugal H.P. 5
Capacity 150 G.P.M.

WELL TESTS:

Drawdown 10 ft. after _____ hours _____ G.P.M.
Drawdown _____ ft. after _____ hours _____ G.P.M.

USE OF WATER Irrigation Temp. _____ °F. _____, 19____

SOURCE OF INFORMATION GR-2148

DRILLER or DIGGER _____

ADDITIONAL DATA:

Log Water Level Measurements _____ Chemical Analysis _____ Aquifer Test _____

REMARKS:

Cemented gravel