

STATE ENGINEER
Salem, Oregon

UMAT
5000

Well Record

STATE WELL NO. 6N/35-34N(2)
COUNTY Umatilla
APPLICATION NO. GR-1256


GR- 1212

OWNER: H. A. Saager
MAILING ADDRESS: Box 183

LOCATION OF WELL: Owner's No. _____
CITY AND STATE: Milton-Freewater, Oregon

SW 1/4 SW 1/4 Sec. 34 T. 6 N. R. 35 E. W.M.

Bearing and distance from section or subdivision
corner 1290' E. & 370' N. from SW cor. Sec. 34.

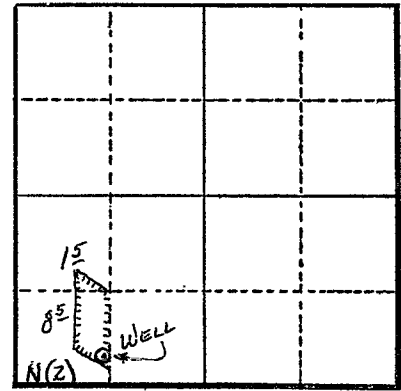

Section 34

Altitude at well 940 ft.

TYPE OF WELL: Dug Date Constructed 1914

Depth drilled 42 ft. Depth cased 12 ft.

CASING RECORD:
5 x 5 ft. concrete curb from 0 to 12 ft.

FINISH:

AQUIFERS:

WATER LEVEL:
12 ft. (early in season)

PUMPING EQUIPMENT: Type Crow 2 1/2 x 3 in. H.P. 3
Capacity _____ G.P.M.

WELL TESTS:
Drawdown 26 ft. after _____ hours 200 G.P.M.
Drawdown _____ ft. after _____ hours _____ G.P.M.

USE OF WATER Irrigation Temp. _____ °F. _____, 19

SOURCE OF INFORMATION G. R. Record

DRILLER or DIGGER _____

ADDITIONAL DATA:
Log N.A. Water Level Measurements _____ Chemical Analysis _____ Aquifer Test _____

REMARKS:
Irrigation of 10 acres.