

STATE ENGINEER  
Salem, Oregon

UMAT  
5002

# Well Record

STATE WELL NO. 6N/35-34Q  
COUNTY Umatilla  
APPLICATION NO. GR-3854

OWNER: Clarence E. Waliser


MAILING ADDRESS: Route 2, Box 57

LOCATION OF WELL: Owner's No.

CITY AND STATE: Milton-Freewater, Oregon

SW 1/4 SE 1/4 Sec. 34 T. 6 N. E. S. R. 35 W., W.M.

Bearing and distance from section or subdivision corner 765.8' N. & 657.7' E. of S 1/4 Cor. Sec. 34

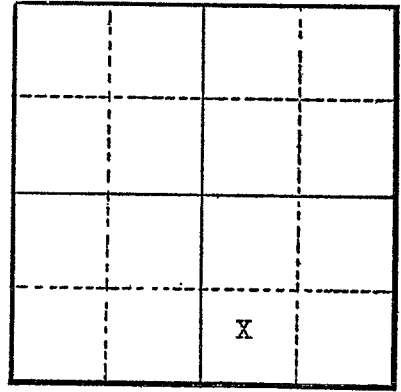

Section 34

Altitude at well

TYPE OF WELL: Dug Date Constructed prior 1912

Depth drilled 52 feet Depth cased 20 feet

### CASING RECORD:

72 inches concrete from 0 to 20 feet

### FINISH:

### AQUIFERS:

### WATER LEVEL:

36 feet below surface

PUMPING EQUIPMENT: Type Wymore centrifugal H.P. 5  
Capacity 450 G.P.M.

### WELL TESTS:

Drawdown ft. after hours G.P.M.  
Drawdown ft. after hours G.P.M.

USE OF WATER Irrigation Temp. °F. 19

SOURCE OF INFORMATION Well Registration Statement Cert. # GR-3510

DRILLER or DIGGER

### ADDITIONAL DATA:

Log Water Level Measurements Chemical Analysis Aquifer Test

### REMARKS: