

STATE ENGINEER
Salem, Oregon

UMAT
5003

Well Record

GR- 1113

STATE WELL NO. 6N/35-34K(1)
COUNTY Umatilla
APPLICATION NO. GR- 1150

OWNER: Wilbur Lawrence Gibbons

MAILING

ADDRESS: Rt. 2, Box 17

LOCATION OF WELL: Owner's No.


CITY AND

STATE: Milton-Freewater, Oregon

N. E.
NW ¼ SE ¼ Sec. 34 T. 6 R. 34 W.M.

Bearing and distance from section or subdivision

corner 15' N. & 15' W. of SE cor. of NW ¼ SE ¼ of
Section 34.

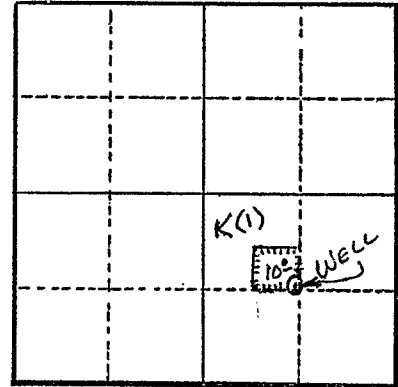

Section 34

Altitude at well 950 ft.

TYPE OF WELL: Dug Date Constructed 1912

Depth drilled 45 ft. Depth cased 10 ft.

CASING RECORD:

6' x 6' concrete from 0 to 10 ft.

FINISH:

AQUIFERS:

WATER LEVEL:

20 ft.

PUMPING EQUIPMENT: Type F. M. 3" Cent. H.P. 5
Capacity 450 G.P.M.

WELL TESTS:

Drawdown 15 ft. after hours 450 (August 1957) G.P.M.

Drawdown ft. after hours G.P.M.

USE OF WATER Irrigation Temp. °F. 19

SOURCE OF INFORMATION G. R. Record

DRILLER or DIGGER

ADDITIONAL DATA:

Log Water Level Measurements Chemical Analysis Aquifer Test

REMARKS:

Log: Top soil 0 to 2 ft.
Gravel 2 to 15 ft.
Cement gravel 15 to 45 ft.

Irrigation of 10 acres.