

STATE ENGINEER  
Salem, Oregon

UMAT  
5004

# Well Record

STATE WELL NO. 6N/35-34E  
COUNTY Umatilla  
APPLICATION NOGR-3166

OWNER: Orville W. Burris


MAILING ADDRESS: Box 484

LOCATION OF WELL: Owner's No.

CITY AND STATE: Milton-Freewater, Oregon

NE  $\frac{1}{4}$  SW  $\frac{1}{4}$  NW  $\frac{1}{4}$  Sec. 34 T. 6 N. S. R. 35 E. W.M.

Bearing and distance from section or subdivision corner 1303' E. and 650' N.

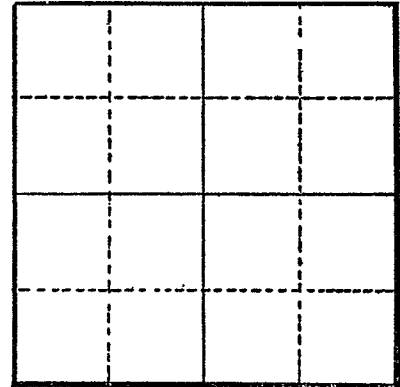

Section .....

Altitude at well

TYPE OF WELL: dug Date Constructed 1912

Depth drilled 65 Depth cased 20

CASING RECORD:  
8 1/2"

FINISH:

AQUIFERS:

WATER LEVEL:  
45 feet

PUMPING EQUIPMENT: Type Centrifugal 1 1/2" H.P. 5  
Capacity 300 G.P.M.

WELL TESTS:

Drawdown ..... ft. after ..... hours ..... G.P.M.  
Drawdown ..... ft. after ..... hours ..... G.P.M.

USE OF WATER Irrigation Temp. .... °F. ...., 19.....

SOURCE OF INFORMATION GR-2964  
DRILLER or DIGGER John Brinker, Route 2, Milton-Freewater, Oregon

ADDITIONAL DATA:

Log ..... Water Level Measurements ..... Chemical Analysis ..... Aquifer Test .....

REMARKS: