

STATE ENGINEER
Salem, Oregon

UMAT
5005

Well Record

STATE WELL NO. 6N/35-34E
COUNTY Umatilla
APPLICATION NO. GR-3167

OWNER: Orville W. Burris


MAILING ADDRESS: Box 484

LOCATION OF WELL: Owner's No. _____

CITY AND STATE: Milton-Freewater, Oregon

NE¹/₄ SW ¹/₄ NW ¹/₄ Sec. 34 T. 6 N. S. R. 35 E. W.M.

Bearing and distance from section or subdivision corner 1332' S. and 1303' E.

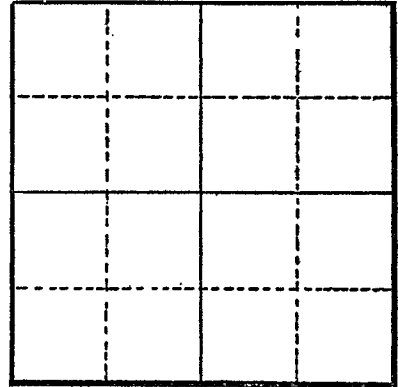

Section _____

Altitude at well _____

TYPE OF WELL dug & drilled Date Constructed 1912

Depth drilled 150 Depth cased 94

CASING RECORD:

14" concrete from 0 to 20'
8" steel from 74 to 94'

FINISH:

AQUIFERS:

WATER LEVEL:

60 feet

PUMPING EQUIPMENT: Type Siberling turbine 1 1/2" H.P. 5
Capacity 300 G.P.M.

WELL TESTS:

Drawdown _____ ft. after _____ hours _____ G.P.M.
Drawdown _____ ft. after _____ hours _____ G.P.M.

USE OF WATER Irrigation Temp. _____ °F. _____, 19____

SOURCE OF INFORMATION GR-2965

DRILLER or DIGGER John Brinker, Route 2, Milton-Freewater, Oregon

ADDITIONAL DATA:

Log _____ Water Level Measurements _____ Chemical Analysis _____ Aquifer Test _____

REMARKS: