

STATE ENGINEER
Salem, Oregon

UMAT
5007

Well Record

STATE WELL NO. 6N/35-34C
COUNTY Umatilla
APPLICATION NO. GR-3169

OWNER: Jesse Reese


MAILING ADDRESS: Route 2, Box 336A

LOCATION OF WELL: Owner's No. #1

CITY AND STATE: Milton-Freewater, Oregon

NE 1/4 NW 1/4 Sec. 34 T. 6 N. 35 E. S. R. W. W.M.

Bearing and distance from section or subdivision corner 10' N. and 20' W.

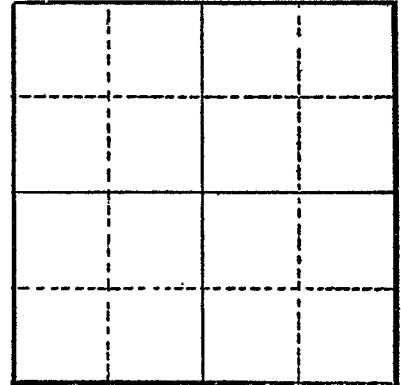

Section

Altitude at well

TYPE OF WELL: dug Date Constructed 1912

Depth drilled 50' Depth cased 15'

CASING RECORD:

60 X 60"

FINISH:

AQUIFERS:

top soil
cemented gravel

WATER LEVEL:

20

PUMPING EQUIPMENT: Type Turbine Pump H.P. 5

Capacity 250 G.P.M.

WELL TESTS:

Drawdown ft. after hours pumping 250 G.P.M.

Drawdown ft. after hours G.P.M.

USE OF WATER Irrigation Temp. °F., 19.....

SOURCE OF INFORMATION GR-2967

DRILLER or DIGGER

ADDITIONAL DATA:

Log Water Level Measurements Chemical Analysis Aquifer Test

REMARKS:

top soil gravelly 3 to 3
cemented gravel 47 to 50