

STATE ENGINEER
Salem, Oregon

UMAT
5008

Well Record

STATE WELL NO. 6N/35-34M(1)
COUNTY Umatilla
APPLICATION NO. GR-1137

GR- 1097

OWNER: Andrew Miller

MAILING
ADDRESS:

Rt. 2, Box 44


LOCATION OF WELL: Owner's No.

CITY AND
STATE:

Milton-Freewater, Oregon

NW ¼ SW ¼ Sec. 34 T. 6 N., R. 35 E., W.M.

Bearing and distance from section or subdivision
corner 1250' E. & 1090' S. from W¼ cor. Sec. 34.

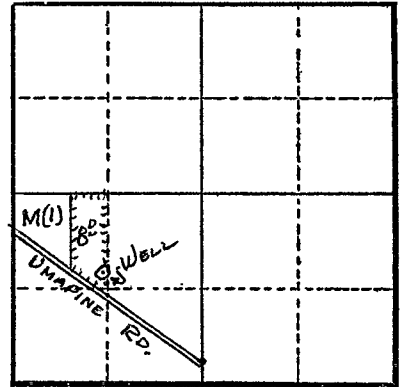

Section 34

Altitude at well 1000 ft.

TYPE OF WELL: Dug Date Constructed 1911

Depth drilled 47 ft. Depth cased 16 ft.

CASING RECORD:

39" x 63" concrete curbing from 0 to 16 ft.

FINISH:

AQUIFERS:

WATER LEVEL:

25 ft. (June reading)

PUMPING EQUIPMENT: Type 2" x 2½" Cent. H.P. 3
Capacity 200 G.P.M.

WELL TESTS:

Drawdown ft. after hours G.P.M.
Drawdown ft. after hours G.P.M.

USE OF WATER Irrigation Temp. °F., 19

SOURCE OF INFORMATION G. R. Record

DRILLER or DIGGER

ADDITIONAL DATA:

Log N.A. Water Level Measurements Chemical Analysis Aquifer Test

REMARKS:

Irrigation of 8 acres.