

STATE ENGINEER  
Salem, Oregon

UMAT  
5809

# Well Record


STATE WELL NO. 6N/35-34A  
COUNTY UMATILLA  
APPLICATION NO. GR-2559

OWNER: Christian Feigner & Carrie Feigner MAILING ADDRESS: R.F.D. 2 Box 346

LOCATION OF WELL: Owner's No. CITY AND STATE: Milton-Freswater, Oregon

NE 1/4 NE 1/4 Sec. 34 T. 6 N. S. R. 35 E. W.M.

Bearing and distance from section or subdivision corner 39 Rds. S. & 35 W.

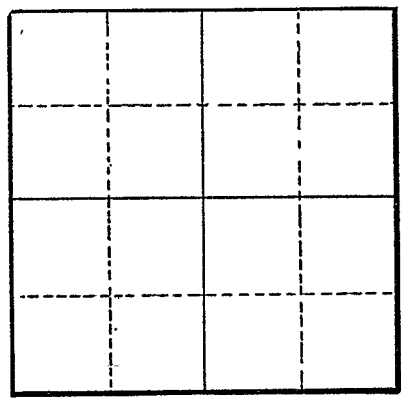

Section

Altitude at well

TYPE OF WELL: Dug-Drilled Date Constructed 1910

Depth drilled 111 Depth cased 53

### CASING RECORD:

60 x 60-inch  
8-inch

### FINISH:

### AQUIFERS:

Rock

### WATER LEVEL:

30-feet

PUMPING EQUIPMENT: Type Centrifugal H.P. 5  
Capacity 250 G.P.M.

### WELL TESTS:

Drawdown 5 ft. after hours Pumping 250 G.P.M.  
Drawdown ft. after hours G.P.M.

USE OF WATER Irrigation Temp. °F., 19

SOURCE OF INFORMATION GR-2417

DRILLER or DIGGER George Shortridge

### ADDITIONAL DATA:

Log X Water Level Measurements Chemical Analysis Aquifer Test

### REMARKS:

Concrete Rock (hard) 57 100  
Concrete rock (soft) 11 111