

STATE ENGINEER  
Salem, Oregon

UMAT  
5010

# Well Record


STATE WELL NO. 6N/35-34G  
COUNTY Umatilla  
APPLICATION NO. GR-4183

OWNER: William J. & Carolyn K. Jackson MAILING ADDRESS: Route 2, Box 318

LOCATION OF WELL: Owner's No. \_\_\_\_\_ CITY AND STATE: Milton-Freewater, Oregon

SW ¼ NE ¼ Sec. 34 T. 6 N. R. 35 E., W.M.

Bearing and distance from section or subdivision corner 1310' E. & 10' N. from center Sec. 34

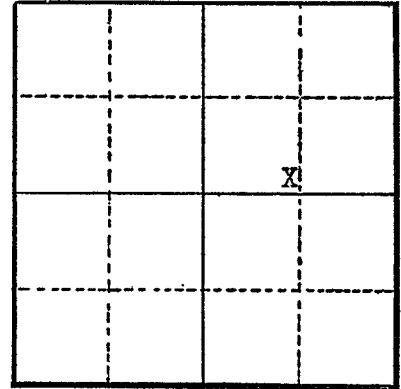

Section 34

Altitude at well \_\_\_\_\_

TYPE OF WELL: Dug & Drill Date Constructed 1910

Depth drilled 80 to 90 ft. Depth cased 80 ft.

### CASING RECORD:

7' x 7' concrete from 0 to 15 ft.  
8 in. steel casing from 65 to 80 ft.

### FINISH:

### AQUIFERS:

### WATER LEVEL:

25 feet below surface

PUMPING EQUIPMENT: Type Pamona turbine H.P. 5  
Capacity 300 G.P.M.

### WELL TESTS:

Drawdown \_\_\_\_\_ ft. after \_\_\_\_\_ hours \_\_\_\_\_ G.P.M.  
Drawdown \_\_\_\_\_ ft. after \_\_\_\_\_ hours \_\_\_\_\_ G.P.M.

USE OF WATER Irrigation Temp. \_\_\_\_\_ °F., 19 \_\_\_\_\_

SOURCE OF INFORMATION Well Registration Statement Cert. # GR-3740

DRILLER or DIGGER \_\_\_\_\_

### ADDITIONAL DATA:

Log \_\_\_\_\_ Water Level Measurements \_\_\_\_\_ Chemical Analysis \_\_\_\_\_ Aquifer Test \_\_\_\_\_

### REMARKS: