

STATE ENGINEER
Salem, Oregon

UMAT
5011

Well Record


STATE WELL NO. 6N/35-34A
COUNTY Umatilla
APPLICATION NO. GR-3018

OWNER: Ned H. Feigner MAILING ADDRESS: Route 2, Box 337

LOCATION OF WELL: Owner's No. CITY AND STATE: Milton Freewater, Oregon

NE ¼ NE ¼ Sec. 34 T. 6N W, R. 35 W, W.M.

Bearing and distance from section or subdivision corner 1310' S. and 650' E. of N¼ cor. Sec. 34

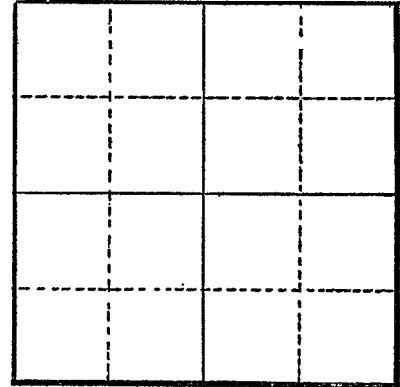

Section

Altitude at well

TYPE OF WELL: dug Date Constructed 1910

Depth drilled 60 Depth cased 20

CASING RECORD:

6 feet

FINISH:

AQUIFERS:

WATER LEVEL:

20 feet

PUMPING EQUIPMENT: Type Fairbanks - Morse Centrifugal H.P. 3
Capacity 350 G.P.M.

WELL TESTS:

Drawdown ft. after hours G.P.M.

Drawdown ft. after hours G.P.M.

USE OF WATER Irrigation Temp. °F., 19.....

SOURCE OF INFORMATION GR-2825

DRILLER or DIGGER

ADDITIONAL DATA:

Log Water Level Measurements Chemical Analysis Aquifer Test

REMARKS: