

STATE ENGINEER
Salem, Oregon

UMAT
5012

Well Record


STATE WELL NO. 6N/35-34
COUNTY UMATILLA
APPLICATION NO. GR-2646

OWNER: Fred S. Groth MAILING ADDRESS: Milton-Freewater,

LOCATION OF WELL: Owner's No. CITY AND STATE: Oregon

$N\frac{1}{2}$ NE $\frac{1}{4}$ SE $\frac{1}{4}$ Sec. 34 T. 6 N. S., R. 35 E. W., W.M.

Bearing and distance from section or subdivision corner 650' S. and 100' W.

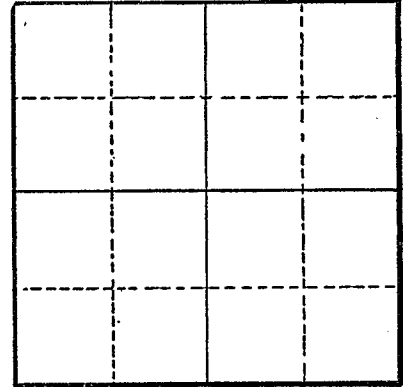

Section

Altitude at well

TYPE OF WELL: Dug & Drilled Date Constructed 1909

Depth drilled 94 Depth cased 94

CASING RECORD:

8-inch
8' x 8'

FINISH:

AQUIFERS:

Topsoil, gravel, and clay

WATER LEVEL:

Various

PUMPING EQUIPMENT: Type Fairbanks Morse H.P. 5
Capacity 400 G.P.M.

WELL TESTS:

Drawdown 10 ft. after hours Pumping 400 G.P.M.
Drawdown 25 ft. after hours Pumping 300 G.P.M.

USE OF WATER Irrigation Temp. °F., 19.....

SOURCE OF INFORMATION GR-2508

DRILLER or DIGGER

ADDITIONAL DATA:

Log Water Level Measurements Chemical Analysis Aquifer Test

REMARKS:

Topsoil	2	2
Gravel	42	44
Cement gravel	8	52
Clay	20	72
Concrete Gravel	22	94