

STATE ENGINEER  
Salem, Oregon

UMAT  
5013

# Well Record

STATE WELL NO. 6N/35-34R(1)  
COUNTY Umatilla  
APPLICATION NO. GR-1155

GR- 1119

OWNER: Anna Muriel Bull

MAILING  
ADDRESS:

LOCATION OF WELL: Owner's No.


CITY AND  
STATE:

Milton-Freewater, Oregon

SE 1/4 SE 1/4 Sec. 34 T. 6 N. R. 35 E. W.M.

Bearing and distance from section or subdivision

corner 545' N. & 20' W. from SE cor. Sec. 34.

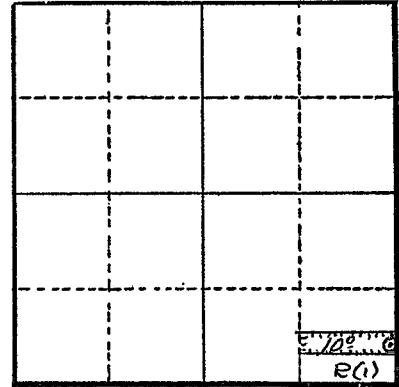

Section 34

Altitude at well 950 ft.

TYPE OF WELL: Dug Date Constructed 1908

Depth drilled 45 ft. Depth cased 12 ft.

### CASING RECORD:

72" x 72" concrete curb from 0 to 12 ft.

### FINISH:

### AQUIFERS:

### WATER LEVEL:

10 ft.

PUMPING EQUIPMENT: Type 2 1/2 x 3 in. Cent. H.P. 7 1/2

Capacity 300 G.P.M.

### WELL TESTS:

Drawdown 30 ft. after 300 hours G.P.M.

Drawdown ft. after hours G.P.M.

USE OF WATER Irrigation Temp. °F., 19

SOURCE OF INFORMATION G. R. Record

DRILLER or DIGGER

### ADDITIONAL DATA:

Log Water Level Measurements Chemical Analysis Aquifer Test

### REMARKS:

Log: Top soil cobbles	0 to 3 ft.
Cement gravel	3 to 35 ft.
Black sand	35 to 37 ft.
Cement gravel	37 to 43 ft.
Black sand	43 to 45 ft.

Irrigation of 10 acres.