

STATE ENGINEER
Salem, Oregon

UMAT
5014

Well Record

STATE WELL NO. 6N/35-34R(2)
COUNTY Umatilla
APPLICATION NO. GR-1156

GR- 1120

OWNER: F. E. & Anna M. Bull


MAILING ADDRESS: _____

LOCATION OF WELL: Owner's No. _____

CITY AND STATE: Milton-Freewater, Oregon

SE 1/4 SE 1/4 Sec. 34 T. 6 N. R. 35 E., W.M.

Bearing and distance from section or subdivision corner 50' W. & 15' N. of SE cor. Sec. 34.

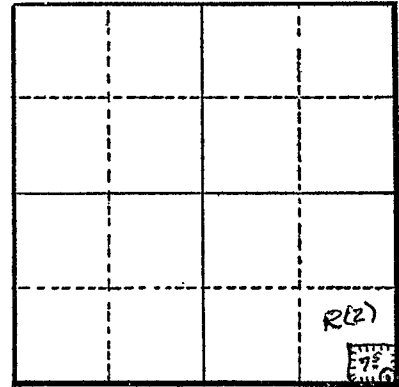

Section 34

Altitude at well 950 ft.

TYPE OF WELL: Dug & Drld Date Constructed 1908

Depth drilled 75 ft. Depth cased 49 ft.

CASING RECORD:

72 x 72 in. from 0 to 10 ft. (concrete curb)
6 in. steel from 33 to 49 ft.

FINISH:

AQUIFERS:

WATER LEVEL:

10 ft.

PUMPING EQUIPMENT: Type 2 1/2 x 3 in. Cent. H.P. 2

Capacity 200 G.P.M.

WELL TESTS:

Drawdown 10 ft. after _____ hours 200 G.P.M.
Drawdown _____ ft. after _____ hours _____ G.P.M.

USE OF WATER Irrigation Temp. _____ °F., 19

SOURCE OF INFORMATION G. R. Record

DRILLER or DIGGER _____

ADDITIONAL DATA:

Log _____ Water Level Measurements _____ Chemical Analysis _____ Aquifer Test _____

REMARKS:

Log: Top soil & gravel 0 to 2 ft.
Cement gravel 2 to 75 ft.

Irrigation of 7 1/2 acres.