

STATE ENGINEER
Salem, Oregon

UMAT
5015

Well Record

STATE WELL NO. 6N/35-34E
COUNTY Umatilla
APPLICATION NO. GR-3489

OWNER: Kyle H. Hubbs


MAILING ADDRESS: Route 2, Box 331

LOCATION OF WELL: Owner's No. _____

CITY AND STATE: Milton-Freewater, Oregon

NE SE 1/4 NW 1/4 Sec. 34 T. 6 N. S., R. 35 E. W., W.M.

Bearing and distance from section or subdivision corner 650' S. and 15' W.

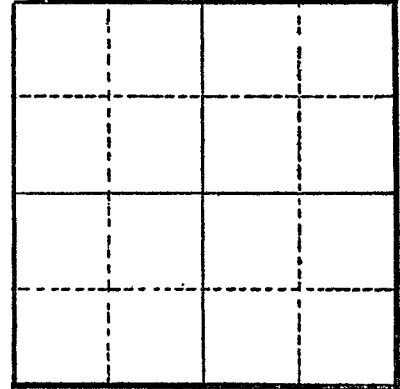

Section _____

Altitude at well _____

TYPE OF WELL: dug & drill Date Constructed 1908

Depth drilled 200' Depth cased 175'

CASING RECORD:

72" and 8"

FINISH:

AQUIFERS:

WATER LEVEL:

20'

PUMPING EQUIPMENT: Type Peerless Turbine 4" H.P. 5
Capacity 335 G.P.M.

WELL TESTS:

Drawdown _____ ft. after _____ hours _____ G.P.M.

Drawdown _____ ft. after _____ hours _____ G.P.M.

USE OF WATER Irrigation Temp. _____ °F. _____, 19_____

SOURCE OF INFORMATION GR-3220

DRILLER or DIGGER Hugue Bros (deceased)

ADDITIONAL DATA:

Log _____ Water Level Measurements _____ Chemical Analysis _____ Aquifer Test _____

REMARKS: