

STATE ENGINEER
Salem, Oregon



Well Record


STATE WELL NO. 6N/35-34H
COUNTY UMATILLA
APPLICATION NO. GR-2329

OWNER: F. A. Feigner
MAILING ADDRESS: Rt. 2, Box 347

LOCATION OF WELL: Owner's No. _____
CITY AND STATE: Milton-Freewater, Oregon

SE 1/4 NE 1/4 Sec. 34 T. 6 N. R. 35 E. W.M.

Bearing and distance from section or subdivision corner 95' W and 10' N.

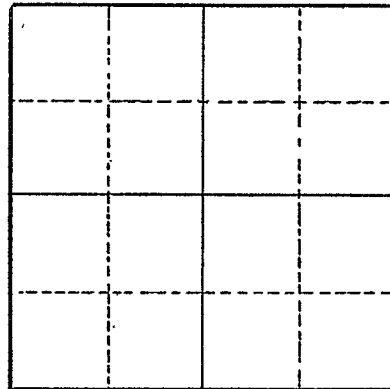

Section _____

Altitude at well _____

TYPE OF WELL: Dug & Drilled Date Constructed 1907

Depth drilled 140 Depth cased 45

CASING RECORD:

8-inch

FINISH:

AQUIFERS:

Topsoil and gravel

WATER LEVEL:

12' to 40' according to season

PUMPING EQUIPMENT: Type Johnson Deep Well Turbine H.P. 3
Capacity 300 G.P.M.

WELL TESTS:

Drawdown 40 ft. after _____ hours Pumping 300 G.P.M.
Drawdown _____ ft. after _____ hours _____ G.P.M.

USE OF WATER Irrigation Temp. _____ °F., 19

SOURCE OF INFORMATION GR-2215

DRILLER or DIGGER _____

ADDITIONAL DATA:

Log Water Level Measurements _____ Chemical Analysis _____ Aquifer Test _____

REMARKS:

Top soil 3' gravel to bottom 140'