

STATE ENGINEER
Salem, Oregon

UMAT
5018

Well Record


STATE WELL NO. 6N/35-34
COUNTY UMATILLA
APPLICATION NO. GR-2338

OWNER: Frank A. Hooker
MAILING ADDRESS: Rt. 2, Box 349

LOCATION OF WELL: Owner's No. _____
CITY AND STATE: Milton-Freewater, Oregon

N¹/₂ SE 1/4 NE 1/4 Sec. 34 T. 6 N. S. R. 35 E. W.M.

Bearing and distance from section or subdivision corner
695' N. and 160' W.

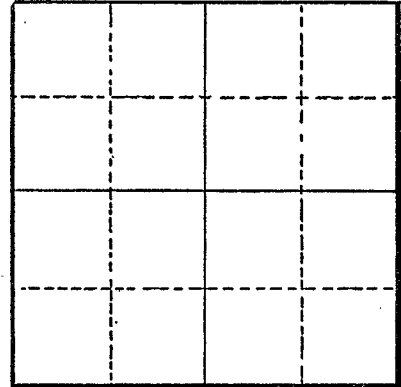

Section

Altitude at well _____

TYPE OF WELL: Dug Date Constructed 1906

Depth drilled 45 Depth cased 30

CASING RECORD:

5' x 6'

FINISH:

AQUIFERS:

WATER LEVEL:

25-feet

PUMPING EQUIPMENT: Type Centrifugal Jacuzzi H.P. 2
Capacity 120 G.P.M.

WELL TESTS:

Drawdown _____ ft. after _____ hours _____ G.P.M.
Drawdown _____ ft. after _____ hours _____ G.P.M.

USE OF WATER Irrigation Temp. _____ °F. _____, 19

SOURCE OF INFORMATION GR-2222

DRILLER or DIGGER _____

ADDITIONAL DATA:

Log _____ Water Level Measurements _____ Chemical Analysis _____ Aquifer Test _____

REMARKS: