

STATE ENGINEER
Salem, Oregon



Well Record

STATE WELL NO. 6N/35-34H
COUNTY Umatilla
APPLICATION NO. GR-3172

OWNER: Jessie Reese


MAILING ADDRESS: Route 2, Box 336 A

LOCATION OF WELL: Owner's No. #1

CITY AND STATE: Milton-Freewater, Oregon

SE 1/4 NE 1/4 Sec. 34 T. 6 N. S. R. 35 E. W. W.M.

Bearing and distance from section or subdivision corner 4' S. and 470' W.

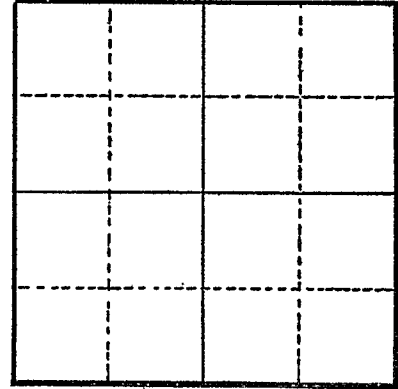

Section

Altitude at well

TYPE OF WELL: dug Date Constructed 1902

Depth drilled 34' Depth cased 15'

CASING RECORD:

60 X 60 concrete curb from 0 to 15'

FINISH:

AQUIFERS:

Top Soil and gravel
Cemented gravel and cobbles

WATER LEVEL:

20'

PUMPING EQUIPMENT: Type 2 1/2" centrifugal H.P. 5
Capacity 250 G.P.M.

WELL TESTS:

Drawdown 8 ft. after hours pumping 250 G.P.M.
Drawdown ft. after hours G.P.M.

USE OF WATER Irrigation Temp. °F., 19.....

SOURCE OF INFORMATION GR-2970

DRILLER or DIGGER

ADDITIONAL DATA:

Log Water Level Measurements Chemical Analysis Aquifer Test

REMARKS:

Top Soil and gravel 0 to 3
Cemented gravel & cobbles 31 to 34