

STATE ENGINEER  
Salem, Oregon

UMAT  
5020

# Well Record

STATE WELL NO. 6N/35-34  
COUNTY UMATILLA  
APPLICATION NO. GR-2642

OWNER: Bertha Rhea


MAILING ADDRESS: Rt. 2, Box 369

LOCATION OF WELL: Owner's No.

CITY AND STATE: Milton-Freewater, Oregon

SW  $\frac{1}{4}$  SE  $\frac{1}{4}$  NE  $\frac{1}{4}$  Sec. 34 T. 6 N. S, R. 35 E. W., W.M.

Bearing and distance from section or subdivision corner 710' W. & 18' N.

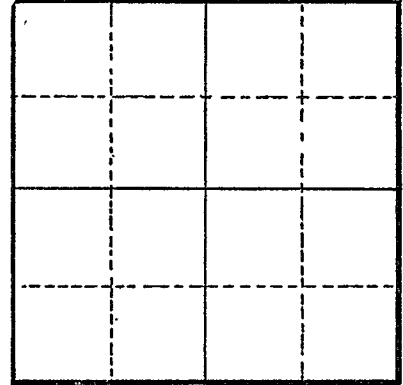

Section

Altitude at well

TYPE OF WELL: Dug & Drilled Date Constructed 1900

Depth drilled 39 & 39 Depth cased 49

### CASING RECORD:

6-feet  
8-inch

### FINISH:

### AQUIFERS:

Concrete rock

### WATER LEVEL:

27-feet

PUMPING EQUIPMENT: Type Centrifugal H.P. 5  
Capacity 450 G.P.M.

### WELL TESTS:

Drawdown 5 ft. after hours Pumping 45 G.P.M.  
Drawdown ft. after hours G.P.M.

USE OF WATER Irrigation Temp. °F., 19

SOURCE OF INFORMATION GR-2504

DRILLER or DIGGER Earl Shortridge

### ADDITIONAL DATA:

Log <sup>X</sup> Water Level Measurements Chemical Analysis Aquifer Test

### REMARKS:

Concrete rock 39 78