

STATE ENGINEER
Salem, Oregon

UMAT
5021

Well Record

STATE WELL NO. 6N/35-34N(1)
COUNTY Umatilla
APPLICATION NO. GR-1158

GR- 1122

OWNER: Clinton G. Graham

MAILING

ADDRESS: Rt. 2, Box 42

LOCATION OF WELL: Owner's No.


CITY AND

STATE: Milton-Freewater, Oregon

SW 1/4 SW 1/4 Sec. 34 T. 6 N. R. 35 E. W., W.M.

Bearing and distance from section or subdivision

corner 630' N. & 980' E. of SW cor. Sec. 34

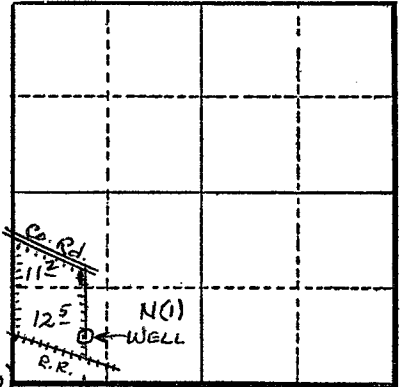

Altitude at well 950 ft.

TYPE OF WELL: Dug & Drl Date Constructed 1900 (Prior to)

Depth drilled 93 ft. Depth cased 41 ft.

Section 34

CASING RECORD:

72 x 72 in. concrete curb from 1 to 20 ft.
8 in. casing steel from 30 to 41 ft.

FINISH:

AQUIFERS:

WATER LEVEL:

20 ft.

PUMPING EQUIPMENT: Type Berkeley 3 in. Cent. H.P. 5
Capacity 300 G.P.M.

WELL TESTS:

Drawdown 9 ft. after hours 300 G.P.M.
Drawdown ft. after hours G.P.M.

USE OF WATER Irrigation Temp. °F. 19

SOURCE OF INFORMATION G. R. Record

DRILLER or DIGGER B. Cornilson - Yakama, Wash.

ADDITIONAL DATA:

Log Water Level Measurements Chemical Analysis Aquifer Test

REMARKS:

Log: Top soil cobbly 0 to 1 1/8 ft.
Cemented sand gravel 1 1/2 to 93 ft.

Irrigation of 23.7 acres.