

STATE ENGINEER
Salem, Oregon

UMIT
5023

Well Record

STATE WELL NO. 6N/35-34K
COUNTY Umatilla
APPLICATION NO. GR-1185


GR- 1146

OWNER: William A. Doherty MAILING ADDRESS: Box 1308

LOCATION OF WELL: Owner's No. CITY AND STATE: Milton-Freewater, Oregon

NW ¼ SE ¼ Sec. 34 T. 6 N. R. 35 E. W.M.

Bearing and distance from section or subdivision corner 1345' W. & 635' S. of E¹/₄ cor. Sec. 34.

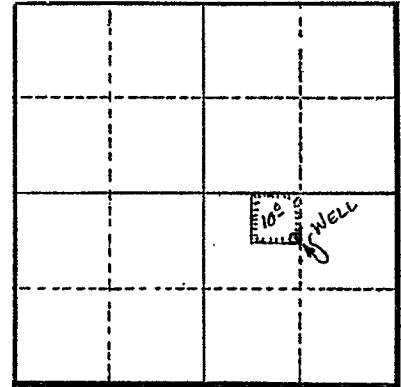

Section 34

Altitude at well 940 ft.

TYPE OF WELL: Dug Date Constructed 1893

Depth drilled 42 ft. Depth cased 12 ft.

CASING RECORD:

8 x 8 ft. concrete ,cement curbing from 0 to 12 ft.

FINISH:

AQUIFERS:

WATER LEVEL:

10 to 12 ft.

PUMPING EQUIPMENT: Type 4 in. turbine H.P. 5
Capacity 350 G.P.M.

WELL TESTS:

Drawdown 5 to 25 ft. after hours 350 G.P.M.
Drawdown ft. after hours G.P.M.

USE OF WATER Irrigation Temp. °F., 19

SOURCE OF INFORMATION G. R. Record

DRILLER or DIGGER

ADDITIONAL DATA:

Log Water Level Measurements Chemical Analysis Aquifer Test

REMARKS:

Log: Top soil 0 to 2 ft.
Gravel 2 to 12 ft.
Cement gravel 12 to 42 ft.

Irrigation of 10 acres.