



# Well Record

STATE WELL NO. 6N/35-34E  
COUNTY Umatilla  
APPLICATION NO.

OWNER: Robert Kordon


MAILING ADDRESS: 930 Emma

LOCATION OF WELL: Owner's No.

CITY AND STATE: Walla Walla, Washington

SW 1/4 NW 1/4 Sec. 34 T. 6 N. R. 35 E., W.M.

Bearing and distance from section or subdivision corner 10' N. & 650' E. of SW cor. NW 1/4 of section 34.

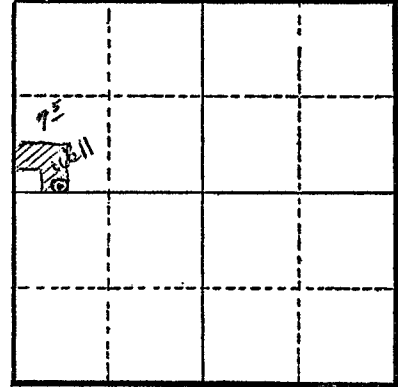

Altitude at well 900 ft.

TYPE OF WELL: Dug Date Constructed

Depth drilled 45 ft. Depth cased 15 ft.

Section 34

CASING RECORD:

60 inch 0 to 15 ft.

FINISH:

AQUIFERS:

WATER LEVEL:

30 ft.

PUMPING EQUIPMENT: Type 6 inch turbine H.P. 3

Capacity 100 G.P.M.

WELL TESTS:

Drawdown 12 ft. after 100 hours G.P.M.

Drawdown ft. after hours G.P.M.

USE OF WATER Dom. & irrigation Temp. °F., 19

SOURCE OF INFORMATION Related registration statement

DRILLER or DIGGER

ADDITIONAL DATA:

Log Water Level Measurements Chemical Analysis Aquifer Test

REMARKS:

Log: Top soil gravelly 0 to 3 ft.  
Cement gravel 3 to 45 ft.