

849

STATE ENGINEER
Salem, Oregon

50W# 849

Well Record

STATE WELL NO. 6N/35-20G1
COUNTY UMATILLA
APPLICATION NO.

umat
50354

J.E. Courneyer

OWNER: Herman Markman

MAILING ADDRESS:

LOCATION OF WELL: Owner's No.

CITY AND STATE:

..... 1/4 1/4 Sec. T. N. E.
S, R. W., W.M.


Bearing and distance from section or subdivision

corner

Altitude at well 734

TYPE OF WELL: Dug Date Constructed

Depth drilled 17 Depth cased

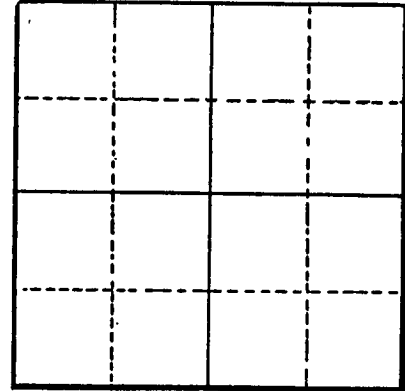

Section

CASING RECORD:

60 inch

FINISH:

AQUIFERS:

Gravel

WATER LEVEL:

1.25 feet below land surface on May 15, 1933

PUMPING EQUIPMENT: Type Centrifugal H.P.
Capacity G.P.M.

WELL TESTS:

Drawdown ft. after hours G.P.M.

Drawdown ft. after hours G.P.M.

USE OF WATER Domestic, Irrigation Temp. °F., 19.....

SOURCE OF INFORMATION USGS

DRILLER or DIGGER

ADDITIONAL DATA:

Log Water Level Measurements X Chemical Analysis Aquifer Test

REMARKS:

Used as water-level observation well.