

STATE ENGINEER
Salem, Oregon

UMAT
5041

Well Record

STATE WELL NO. 6N/35-35C
COUNTY Umatilla
APPLICATION NO. GR-4162

OWNER: Clarence C. Anspach

MAILING ADDRESS:

Route 3, Box 355


LOCATION OF WELL: Owner's No.

CITY AND STATE:

Milton-Freewater, Oregon

NE 1/4 NW 1/4 Sec. 35 T. 6 N. R. 35 E. W.M.

Bearing and distance from section or subdivision corner 990' S. 110' W. NE Cor. NW 1/4 Sec. 35

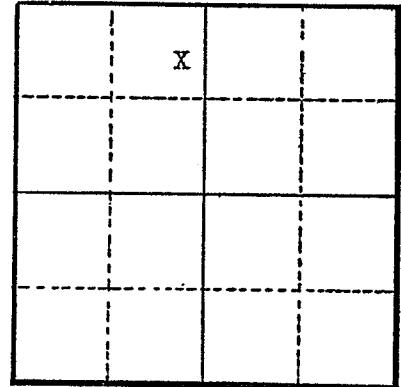

Section 35

Altitude at well

TYPE OF WELL: Dug Date Constructed 1880

Depth drilled 60 ft. Depth cased 15 ft.

CASING RECORD:

72 inch cemented rock curb from 0 to 15 feet

FINISH:

AQUIFERS:

WATER LEVEL:

50 feet below surface

PUMPING EQUIPMENT: Type Jet pump H.P. 1
Capacity 150 G.P.M.

WELL TESTS:

Drawdown 1 ft. after 150 hours G.P.M.
Drawdown ft. after hours G.P.M.

USE OF WATER Irrigation Temp. °F., 19
SOURCE OF INFORMATION Well Registration Statement Cert. # GR-3728

DRILLER or DIGGER

ADDITIONAL DATA:

Log Water Level Measurements Chemical Analysis Aquifer Test

REMARKS: Log

Top soil gravelly
Cemented gravel & rock

Thickness	Depth to Bottom
3	3
57	60