

UMAT  
5106

Well Record

STATE WELL NO. 6N/35-35B  
COUNTY UMATILLA  
APPLICATION NO. GR-2102

OWNER: Paul Redfearn


MAILING ADDRESS: Route 3, Box 344

LOCATION OF WELL: Owner's No. \_\_\_\_\_

CITY AND STATE: Milton - FREEWATER, ORE

NE 1/4 NW 1/4 NE 1/4 Sec. 35 T. 6 N. 8, R. 35 W., W.M.

Bearing and distance from section or subdivision corner 30' W and 17' N  
1400' W & 600' S

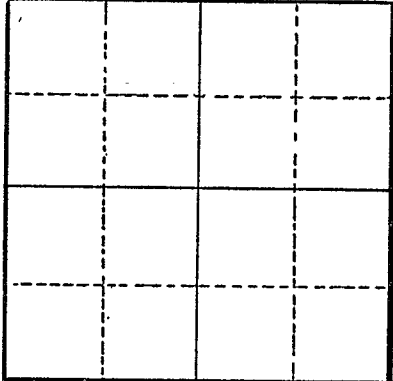

Section \_\_\_\_\_

Altitude at well \_\_\_\_\_

TYPE OF WELL: Drill Date Constructed 1923

Depth drilled 72 Depth cased 40 72

CASING RECORD:

5 x 6 Feet  
10 - Inch

FINISH:

AQUIFERS:

Top Soil - 1 1  
Cemented Gravel 71 72

WATER LEVEL:

50 1/2 - Feet

PUMPING EQUIPMENT: Type Fairbanks Centrifugal H.P. 3  
Capacity 150 G.P.M.

WELL TESTS:

Drawdown 12-15 ft. after \_\_\_\_\_ hours Pumping 150 G.P.M.  
Drawdown \_\_\_\_\_ ft. after \_\_\_\_\_ hours \_\_\_\_\_ G.P.M.

USE OF WATER Irrigation Temp. \_\_\_\_\_ °F. \_\_\_\_\_, 19\_\_\_\_

SOURCE OF INFORMATION GR-2019

DRILLER or DIGGER Jim Overholt

ADDITIONAL DATA:

Log X Water Level Measurements \_\_\_\_\_ Chemical Analysis \_\_\_\_\_ Aquifer Test \_\_\_\_\_

REMARKS:

Top Soil 1 1  
Cemented gravel 71 72