

STATE ENGINEER
Salem, Oregon

UMAT
5102

Well Record

GR-1123


STATE WELL NO. 6N/35-35N(1)
COUNTY Umatilla
APPLICATION NO. GR-1159

OWNER: Ellis C. Zerba
MAILING ADDRESS: Rt. 1, Box 2

LOCATION OF WELL: Owner's No. _____
CITY AND STATE: Milton-Freewater, Oregon

SW 1/4 SW 1/4 Sec. 35 T. 6 N. S, R. 35 E. W., W.M.

Bearing and distance from section or subdivision
corner 83' N. & 9' W. from SE cor. of SW 1/4 SW 1/4 of
Section 35.

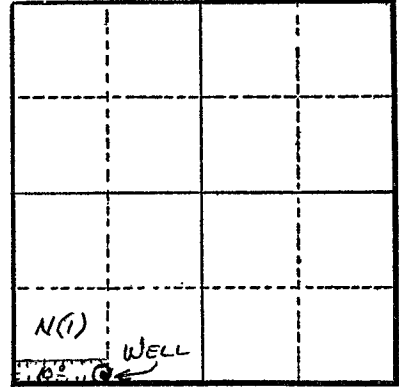

Section 35

Altitude at well 975 ft.

TYPE OF WELL: Dug Date Constructed 1923

Depth drilled 35 ft. Depth cased 10 ft.

CASING RECORD:

6 x 6 ft. concrete curb from 0 to 10 ft.

FINISH:

AQUIFERS:

WATER LEVEL:

15 ft.

PUMPING EQUIPMENT: Type 1 1/2 in. Cent. H.P. 3
Capacity 150 G.P.M.

WELL TESTS:

Drawdown 10 ft. after _____ hours 150 G.P.M.
Drawdown _____ ft. after _____ hours _____ G.P.M.

USE OF WATER Irrigation Temp. _____ °F., 19

SOURCE OF INFORMATION G. R. Record

DRILLER or DIGGER _____

ADDITIONAL DATA:

Log _____ Water Level Measurements _____ Chemical Analysis _____ Aquifer Test _____

REMARKS:

log: Top soil 0 to 2 ft.
Gravel 2 to 35 ft.

Irrigation of 10 acres.