

STATE ENGINEER
Salem, Oregon

UMAT
5103

Well Record


STATE WELL NO. 6N/35 - 35D
COUNTY UMATILLA
APPLICATION NO. GR-1990

OWNER: Clarence C. Brunner MAILING ADDRESS: Rt. 3, Box 302

LOCATION OF WELL: Owner's No. _____ CITY AND STATE: Milton-Freewater, Oregon

NW ¼ NW ¼ Sec. 35 T. 6 N. S, R. 35 E. W, W.M.

Bearing and distance from section or subdivision corner 528' N. and 164' E.

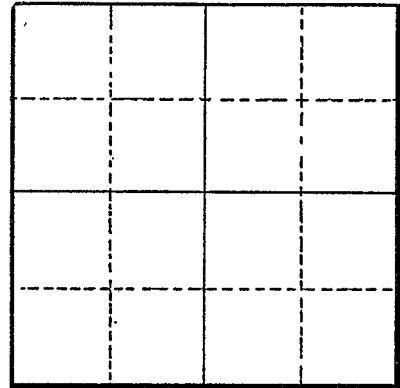

Section _____

Altitude at well _____

TYPE OF WELL: Dug Date Constructed 1920

Depth drilled 45 Depth cased 15

CASING RECORD:

6-feet

FINISH:

AQUIFERS:

WATER LEVEL:

20-feet

PUMPING EQUIPMENT: Type Fairbanks Morse 3" Centrifugal H.P. 3
Capacity 300 G.P.M.

WELL TESTS:

Drawdown _____ ft. after _____ hours _____ G.P.M.

Drawdown _____ ft. after _____ hours _____ G.P.M.

USE OF WATER Irrigation Temp. _____ °F. _____, 19____

SOURCE OF INFORMATION GR-1921

DRILLER or DIGGER Alex LeFore Sr.

ADDITIONAL DATA:

Log _____ Water Level Measurements _____ Chemical Analysis _____ Aquifer Test _____

REMARKS: