

STATE ENGINEER
Salem, Oregon

UMAT
5104

Well Record

STATE WELL NO. 6N/35-35E(1)
COUNTY Umatilla
APPLICATION NO. GR-1151

GR- 1115

OWNER: J. H. Murphy

MAILING ADDRESS: Rt. 2, Box 352


LOCATION OF WELL: Owner's No. #1

CITY AND STATE: Milton-Freewater, Oregon

SW 1/4 NW 1/4 Sec. 35 T. 6 N. S. R. 35 W., W.M.

Bearing and distance from section or subdivision

corner 3' N. & 3' W. of SE cor. SW 1/4 NW 1/4 of Sec. 35.

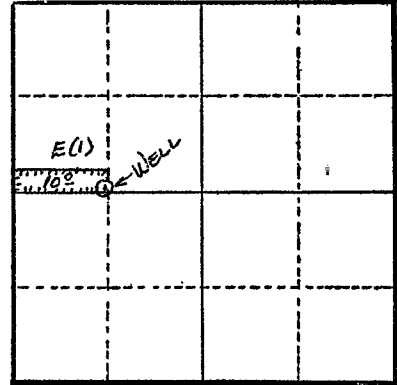

Section 35

Altitude at well 880 ft.

TYPE OF WELL: Dug Date Constructed 1917

Depth drilled 40 ft. Depth cased 10 ft.

CASING RECORD:

8' x 8' concrete from 0 to 10 ft.

FINISH:

AQUIFERS:

WATER LEVEL:

10 ft. (measured in June)

PUMPING EQUIPMENT: Type Pacific Cent. H.P. 3
Capacity 300 G.P.M.

WELL TESTS:

Drawdown 25 ft. after 300 (June 157) G.P.M.
Drawdown 38 ft. after 200 (Sept. 157) G.P.M.

USE OF WATER Irrigation Temp. °F. 19

SOURCE OF INFORMATION G. R. Record

DRILLER or DIGGER

ADDITIONAL DATA:

Log Water Level Measurements Chemical Analysis Aquifer Test

REMARKS:

Log: Top soil 0 to 2 ft.
Gravel 2 to 40 ft.

Irrigation of 10 acres.