

STATE ENGINEER
Salem, Oregon

UMAT
~~5104~~
5105

Well Record

GR- 1116


STATE WELL NO. 6N/35-35M(2)
COUNTY Umatilla
APPLICATION NO. GR- 1152

OWNER: J. H. Murphy
MAILING ADDRESS: Rt. 2, Box 352

LOCATION OF WELL: Owner's No. #2
CITY AND STATE: Milton-Freewater, Oregon

N. E.
NW 1/4 SW 1/4 Sec. 35 T. 6 R. 35, W.M.

Bearing and distance from section or subdivision
corner 320' S. & 10' W. of NE cor. of NW 1/4 of
Section 35.

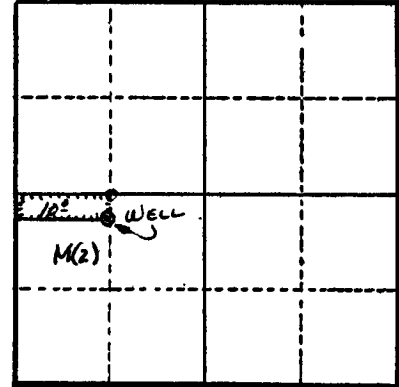

Section 35

Altitude at well 880 ft.

TYPE OF WELL: Dug Date Constructed 1915

Depth drilled 40 ft. Depth cased 10 ft.

CASING RECORD:

8' x 8' concrete from 0 to 10 ft.

FINISH:

AQUIFERS:

WATER LEVEL:

10 ft. (measured in June - dry in Winter)

PUMPING EQUIPMENT: Type Pacific Cent. H.P. 3

Capacity 250 G.P.M.

WELL TESTS:

Drawdown 25 ft. after 250 (June) G.P.M.

Drawdown 38 ft. after 150 (Sept.) G.P.M.

USE OF WATER Irrigation Temp. °F. 19

SOURCE OF INFORMATION G. R. Record

DRILLER or DIGGER

ADDITIONAL DATA:

Log Water Level Measurements Chemical Analysis Aquifer Test

REMARKS:

Log: Top soil 0 to 2 ft.
Gravel 2 to 40 ft.

Irrigation of 10 acres.