

STATE ENGINEER
Salem, Oregon

UMAT
5106

Well Record

GR- 1394


STATE WELL NO. 6N/35-35E
COUNTY Umatilla
APPLICATION NO. GR- 1447

OWNER: Claude Bradfield MAILING ADDRESS: Rt. 3

LOCATION OF WELL: Owner's No. #2 CITY AND STATE: Milton-Freewater, Oregon

SW $\frac{1}{4}$ NW $\frac{1}{4}$ Sec. 35 T. 6 ~~XX~~ R. 35 ~~XX~~ E. W.M.

Bearing and distance from section or subdivision corner 315' N. from a pt. 10' W. from SE cor. of NE $\frac{1}{4}$ of SW $\frac{1}{4}$ of NW $\frac{1}{4}$ of Sec. 35.

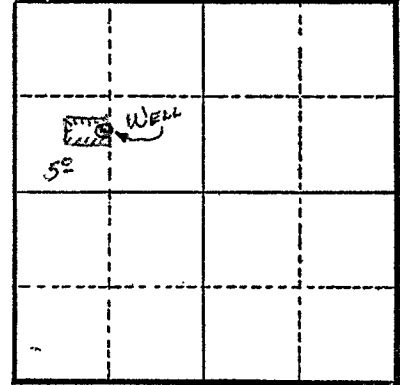

Section 35

Altitude at well 875'

TYPE OF WELL: Dug&Drill'd Date Constructed 1910

Depth drilled 105' Depth cased 10'

CASING RECORD:

10"

FINISH:

AQUIFERS:

WATER LEVEL:

15'

PUMPING EQUIPMENT: Type F. M. 2 $\frac{1}{2}$ " H.P. 3
Capacity 300 G.P.M.

WELL TESTS:

Drawdown 10 ft. after 350 hours 350 G.P.M.
Drawdown ft. after hours G.P.M.

USE OF WATER Irrigation Temp. °F. , 19

SOURCE OF INFORMATION GR Record

DRILLER or DIGGER Earl Shortridge

ADDITIONAL DATA:

Log Water Level Measurements Chemical Analysis Aquifer Test

REMARKS:

Log: Top soil 0 to 2'
Gravel 2' to 105'

Irrigation of 5 acres.