

STATE ENGINEER
Salem, Oregon

UMAT
5107

Well Record

STATE WELL NO. 6N/35-35E
COUNTY Umatilla
APPLICATION NO. GR-1448

GR- 1395

OWNER: Claude Bradfield


MAILING ADDRESS: Rt. 2, Box 351

LOCATION OF WELL: Owner's No. #3

CITY AND STATE: Milton-Freewater, Oregon

SW 1/4 NW 1/4 Sec. 35 T. 6 N. R. 35 E. W.M.

Bearing and distance from section or subdivision
corner 345' N. & 10' W. from SE cor. of SW 1/4 of
NW 1/4 of Sec. 35.

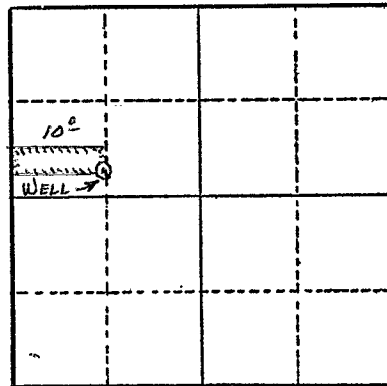

Section 35

Altitude at well 900'

TYPE OF WELL: Dug Date Constructed 1909

Depth drilled 40' Depth cased 12'

CASING RECORD:

8' x 8' concrete

FINISH:

AQUIFERS:

WATER LEVEL:

20'

PUMPING EQUIPMENT: Type Pacific 3" Cent. H.P. 5
Capacity 450 G.P.M.

WELL TESTS:

Drawdown ft. after hours G.P.M.
Drawdown ft. after hours G.P.M.

USE OF WATER Irrigation Temp. °F. 19

SOURCE OF INFORMATION GR Record

DRILLER or DIGGER

ADDITIONAL DATA:
Log Water Level Measurements Chemical Analysis Aquifer Test

REMARKS:

Log: Top soil 0 to 2'
Gravel 2' to 14'
Cement gravel 14' to 40'

Irrigation of 10 acres.