

STATE ENGINEER  
Salem, Oregon

UMAT  
5108

# Well Record

STATE WELL NO. ...6N/35-35M.  
COUNTY ...Umatilla  
APPLICATION NO. GR-1446

GR- 1393

OWNER: Claude Bradfield


MAILING ADDRESS: Rt. 2, Box 351

LOCATION OF WELL: Owner's No. #1

CITY AND STATE: Milton-Freewater, Oregon

NW 1/4 SW 1/4 Sec. 35 T. 6 N. R. 35 E. W.M.

Bearing and distance from section or subdivision corner 650' S. & 6' W. from NE cor. NW 1/4 SW 1/4 of Section 35.

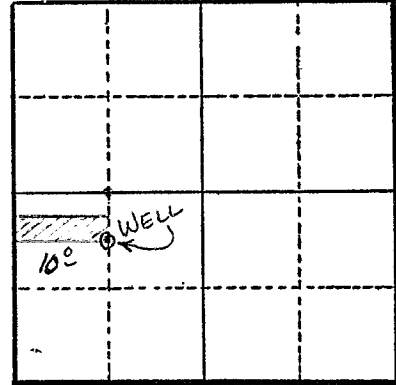

Section 35

Altitude at well 900'

TYPE OF WELL: Dug & Drill'd Date Constructed 1909

Depth drilled 73' Depth cased 47'

### CASING RECORD:

- 8' x 8' concrete from 0 to 12'
- 8" steel from 37' to 47'

### FINISH:

### AQUIFERS:

### WATER LEVEL:

20 ft.

PUMPING EQUIPMENT: Type G. E. 2 1/2" H.P. 3  
Capacity 300 G.P.M.

### WELL TESTS:

Drawdown ..... ft. after ..... hours ..... G.P.M.

Drawdown ..... ft. after ..... hours ..... G.P.M.

USE OF WATER Irrigation Temp. °F. 19

SOURCE OF INFORMATION GR Record

DRILLER or DIGGER

ADDITIONAL DATA:

Log ..... Water Level Measurements ..... Chemical Analysis ..... Aquifer Test .....

### REMARKS:

Log: Top soil 0 to 2'  
Gravel 2' to 14'  
Cemented gravel 14' to 73'

Irrigation of 10 acres.