

STATE ENGINEER  
Salem, Oregon

UMAT  
5109

# Well Record

STATE WELL NO. 6N/35-35M  
COUNTY Umatilla  
APPLICATION NO. GR-1148

GR- 1111

OWNER: William Franklin Tawn


MAILING ADDRESS: Rt. 2, Box 358

LOCATION OF WELL: Owner's No. \_\_\_\_\_

CITY AND STATE: Milton-Freewater, Oregon

NW  $\frac{1}{4}$  SW  $\frac{1}{4}$  Sec. 35 T. 6 N., R. 35 E., W.M.

Bearing and distance from section or subdivision corner 1330' N. & 1310' E. from SW cor. Sec. 35.

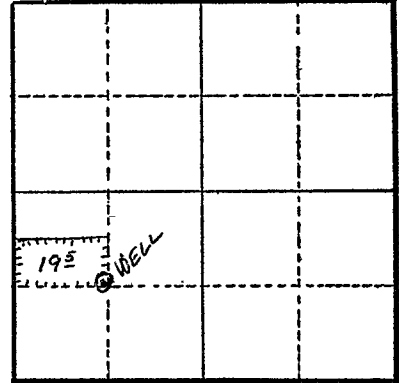

Section 35

Altitude at well 1005 ft.

TYPE OF WELL: Dug Date Constructed 1909

Depth drilled 45 ft. Depth cased \_\_\_\_\_

### CASING RECORD:

### FINISH:

### AQUIFERS:

### WATER LEVEL:

18 ft.

PUMPING EQUIPMENT: Type Cent. H.P. 7 1/2  
Capacity 350 G.P.M.

### WELL TESTS:

Drawdown \_\_\_\_\_ ft. after \_\_\_\_\_ hours \_\_\_\_\_ G.P.M.  
Drawdown \_\_\_\_\_ ft. after \_\_\_\_\_ hours \_\_\_\_\_ G.P.M.

USE OF WATER Irrigation Temp. \_\_\_\_\_ °F., 19

SOURCE OF INFORMATION G. R. Record

DRILLER or DIGGER \_\_\_\_\_

### ADDITIONAL DATA:

Log N.A. Water Level Measurements \_\_\_\_\_ Chemical Analysis \_\_\_\_\_ Aquifer Test \_\_\_\_\_

### REMARKS:

Irrigation of 19 1/2 acres.