

STATE ENGINEER
Salem, Oregon

UMAT
5111

Well Record


STATE WELL NO. 6N/35-35N
COUNTY Umatilla
APPLICATION NO. GR-4076

OWNER: Mrs. Robert Preas
MAILING ADDRESS: Route 2, Box 364

LOCATION OF WELL: Owner's No. _____
CITY AND STATE: Milton-Freewater, Oregon

SW 1/4 SW 1/4 Sec. 35 T. 6 N. E. R. 35 W., W.M.

Bearing and distance from section or subdivision
corner 980' S. 20' W. NE Cor. SW 1/4 SW 1/4

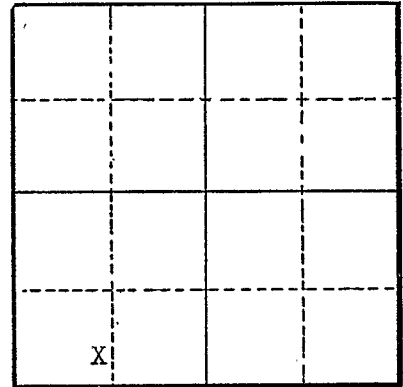

Section 35

Altitude at well _____

TYPE OF WELL: Dug Date Constructed 1908 prior

Depth drilled 30 ft. Depth cased 12 ft.

CASING RECORD:

60 x 60 inch concrete curb from 0 to 12 feet

FINISH:

AQUIFERS:

WATER LEVEL:

20 feet below surface

PUMPING EQUIPMENT: Type centrifugal 2 1/2" H.P. 3

Capacity 75 - 300 G.P.M.

WELL TESTS:

Drawdown 5' - 9' ft. after _____ hours 200 G.P.M.

Drawdown _____ ft. after _____ hours _____ G.P.M.

USE OF WATER Irrigation Temp. _____ °F. _____, 19

SOURCE OF INFORMATION Well Registration Statment Cert. # GR-3672

DRILLER or DIGGER _____

ADDITIONAL DATA:

Log Water Level Measurements _____ Chemical Analysis _____ Aquifer Test _____

REMARKS:

Log:

Top soil rocky
cemented rocky & gravel

Thickness	Depth to Bottom
3	3
27	30