

STATE ENGINEER
Salem, Oregon



Well Record


STATE WELL NO. 6N/35-35N
COUNTY Umatilla
APPLICATION NO. GR-4075

OWNER: Mrs. Robert Preas MAILING ADDRESS: Route 2, Box 364

LOCATION OF WELL: Owner's No. _____ CITY AND STATE: Milton-Freewater, Oregon

SW $\frac{1}{4}$ SW $\frac{1}{4}$ Sec. 35 T. 6 N. R. 35 E. W.M.

Bearing and distance from section or subdivision corner 350' S. 10' W. of NE Cor. SW $\frac{1}{4}$ SW $\frac{1}{4}$

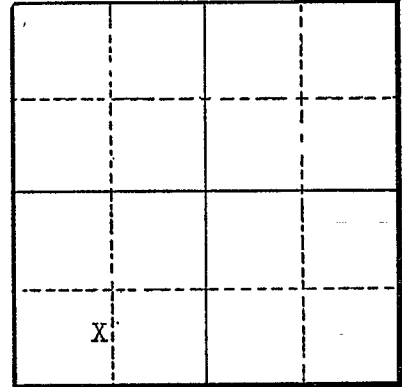

Section 35

Altitude at well _____

TYPE OF WELL: Dug Date Constructed 1908 prior

Depth drilled 30 ft. Depth cased 10 ft.

CASING RECORD:

60 x 60 inch concrete curb from 0 to 10 feet

FINISH:

AQUIFERS:

WATER LEVEL:

20 feet below surface

PUMPING EQUIPMENT: Type centrifugal 2 $\frac{1}{2}$ " dischg. H.P. 3

Capacity 75 to 300 G.P.M.

WELL TESTS:

Drawdown 5' - 9' ft. after _____ hours 200 G.P.M.

Drawdown _____ ft. after _____ hours _____ G.P.M.

USE OF WATER Irrigation Temp. _____ °F. _____, 19

SOURCE OF INFORMATION Well Registration Statement Cert. # GR-3671

DRILLER or DIGGER _____

ADDITIONAL DATA:

Log X Water Level Measurements _____ Chemical Analysis _____ Aquifer Test _____

REMARKS:

Log:

Top soil rocky
cemented rock & gravel

Thickness	Depth to Bottom
2	2
28	30